PHONE: 610-926-4920 FAX: 610-926-6314

MAIDENCREEK TOWNSHIP
BOARD OF SUPERVISORS

1 QUARRY ROAD * P.O. BOX 319 * BLANDON, PA 19510
www.maidencreek.net

February 14, 2017

Stoney Creek Rentals
PO Box 99
Blandon, PA 19510

Re: Plan Action Letter

Dear Mr. Shirk,

The Maidencreek Township Board of Supervisors at their February 9, 2017 meeting granted the Stoney Creek Warehouse Expansion Plan two waivers to the Code of Ordinances of Maidencreek township. The first waiver is to Section 190.23 to allow the plan to be reviewed as preliminary/final and the second waiver is to Section 193.34B to waive the sidewalk requirement.

The Board of Supervisors also granted final plan approval to the Stoney Creek Rentals Warehouse Expansion Plan conditioned up receipt of the Penn DOT Highway Occupancy Permit or proof of an existing Highway Occupancy Permit, a deed combining both parcels which is recorded prior to or with the recording of the plan, and the owner's notarized signature on the plan. All conditions shall be satisfied within forty-five (45) days.

Best regards,

Diane Hollenbach

Diane Hollenbach
Manager
Maidencreek Township

pennsylvania
DEPARTMENT OF TRANSPORTATION

Date: 03/24/2017

Subject: Highway Occupancy Permit Application No. 126109 Returned For Revisions

To: Stoney Creek Rentals
872 Park Road
PO Box 99
Blandon, PA 19510

From: PennDOT Engineering District 5-0
1002 Hamilton Street
Allentown, PA 18101

Dear Applicant,

PennDOT has reviewed your application for completeness, consistency and compliance with applicable Department Regulations. This review has identified issues that must be addressed in order for our review to continue.

The Department's review comments are attached.

Once the comments have been addressed, please resubmit the application and associated material for further review.

Upon resubmission, the applicant's engineer should put together a letter that describes how each comment has been addressed and where each can be found. This will help expedite the review. For guidance on HOP applications refer to 67 PA Code, Chapter 441, Chapter 459 and PennDOT Publication 282, "Highway Occupancy Permit Guidelines". Additional comments may follow upon review of the resubmitted application.

If you have any questions regarding this matter, you may contact Jeremiah Shirock, District Permit Manager, at (610) 871-4465 or via email at jshirock@pa.gov.

pennsylvania
DEPARTMENT OF TRANSPORTATION

Response Comments
Date: 03/24/2017
Application Number: 126109

General

(1) Please continue to provide Township review comments and/or approvals with your resubmission. Copies of the review letters referenced in the February 2, 2017 Planning Commission letter should be provided, unless more recent reviews and/or approvals are available.

(2) PennDOT Form M-950MPC, Land Use Questionnaire, must be completed and signed by the applicant(s). Refer to below "application" comments. (Sections 619.2 and 1105 of the Municipal Planning Code and PennDOT Publication 282, Chapter 3.3)

Application

(1) The Agent Authorization Form M-950AA must be signed by the applicant(s). Refer to below comment. Also note that if the authorization is a "blanket" authorization, then the first section must be listed as "N/A".

(2) An incorrect permit fee was submitted. A check/money order in the amount of $50.00 is required. (Pa. Code Title 67, Chapter 441.4)

(3) Please update the "Application Identification" section of EPS to provide the average daily trips for each of the types of vehicles using the driveway. Pa Code Title 67, Chapter 441.3(e)(1)

(4) The application must be submitted in the name of the person who holds fee title to the land or a person who holds an estate or other legal interest in property, such as an easement, a lease, a license, subsurface rights, or an equitable interest under a sales agreement or option to purchase. The deed provided lists the property owners as Samuel S. Shirk and Anna M. Shirk, however, the EPS application is in the name of Stoney Creek Rentals. If the applicant in this application is not a fee owner of the property, Form M-950 RFO (Release of Fee Owner) is required, along with documentation showing the applicant's interest in the property. (Pa Code Title 67, Chapter 441.3(b) and 441.5(b))

(5) Note that the "Applicant Team" section in EPS has been revised by the Department. The co-applicant information has been provided under the section for additional applicant contact information. Driveway permits would typically be issued with co-applicants only when the driveway is physically located on two properties with two separate property owners (joint-use driveway). As the Department reviewers cannot remove a "co-applicant" from the application, please update this information prior to resubmission.

Plan Presentation

(1) Provide the distance from the driveway to the nearest intersection and to the nearest driveway on both sides of the road on the plans. Pa Code, Title 67, Chapter 441.3. Refer to attached markups for clarification.

(2) List the expected ADT's for the proposed driveway in trips and vehicles on the HOP plan. (Pa. Code, Title 67, Chapter 441.3(i)(7))

(3) Reference the HOP application number on the plan set. (Pa. Code, Title 67, Chapter 441.3)

(4) Specify all existing Right-of-Way as either PennDOT Legal Right-of-Way or Township Legal Right-of-Way.

(5) The title sheet must have a black ink rubber stamp Pennsylvania Registered Professional Engineer seal and signature per Design Manual, Part 3, Chapter 2.1.K, page 2-7.

(6) The applicant should refer to the marked-up plans to assist in the clarification of comments. The marked-up plans can be found on the "attachments" screen in EPS.

Access Configuration/Profile- Driveways/Local Roads

(1) Revise the plans such that the difference between the cross slope of the shoulder and the grade of the driveway does not exceed eight percent. If it is not practical for a grade difference of eight percent or less to be achieved, a vertical curve must be provided in accordance with Figure 1 of the (Pa. Code, Title 67, Chapter 441.8(i)(4) and Figure 1)

Signs

(1) A "Stop" sign (R1-1) sized 30" x 30" should be shown for the driveway exit.

Pavement Markings

(1) Label all existing pavement markings within the project limits on the plans. Pa Code, Title 67, Chapter 441.3(i)(1)

HOP	DISTRICT	COUNTY	TOWNSHIP	BOROUGH	ROUTE	SECTION	TOTAL SHEETS
	5-0	BERKS	MAIDENCREEK	–	1010	–	3


PAGE	DESCRIPTION	LAST REVISED
1 OF 3	COVER SHEET	02/24/17
2 OF 3	PLAN	02/24/17
3 OF 3	GENERAL NOTES	02/24/17

HIGHWAY OCCUPANCY PERMIT PLANS
FOR
STONEY CREEK RENTALS

LOW VOLUME DRIVEWAY

SR1010 (PARK ROAD)
MAIDENCREEK TOWNSHIP, BERKS COUNTY, PENNSYLVANIA

Please increase text size
Minimum is 0.12" per
Design Manual Part 3

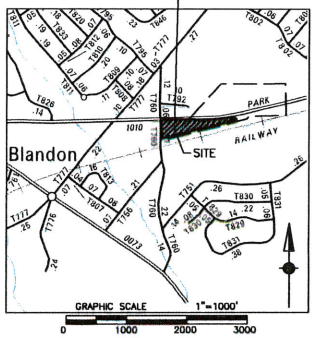

FROM STA. _____ TO STA. _____ LENGTH _____ FT. _____ MI.

FROM SEG. 0050 OFFSET 1717 TO SEG. 0050 OFFSET 1717

Not required if no physical work in PennDOT is proposed

verify - see sheet 2

EPS APPLICATION # 126109

PENNSYLVANIA ONE CALL SYSTEM

925 IRWIN RUN ROAD
WEST MIFFLIN, PENNSYLVANIA
15122-1078

Use current logo
Refer to sample
Bill sheet in EPS

BEFORE YOU DIG ANYWHERE IN
PENNSYLVANIA! CALL 1-800-242-1776
NON-MEMBERS MUST BE CONTACTED DIRECTLY
PA LAW REQUIRES THREE WORKING DAYS
NOTICE TO UTILITIES BEFORE YOU EXCAVATE,
DRILL, BLAST OR DEMOLISH

SERIAL NO. 20163561405

PREPARED FOR:

STONEY CREEK RENTALS

827 PARK ROAD

BLANDON, PA 19510

SAMUEL S. SHIRK & ANNA M. SHIRK

49 RIDGE STREET

FLEETWOOD, PA 19522

DESIGN DESIGNATION

HIGHWAY CLASSIFICATION – URBAN MINOR ARTERIAL
ROADWAY TYPOLOGY – COMMUNITY ARTERIAL

DESIGN SPEED – 45 MPH

PAVEMENT WIDTH – EB – 11'
WB – 11'

SHOULDER WIDTH – EB – 5'
WB – 5'

TRAFFIC DATA

CURRENT A.D.T. – 13,000 (13,444 (2017))

DESIGN YEAR A.D.T. – 13,832 (2022)

D.H.V. – X,XXX (1245)

D – XX% (65%)

T – X% (4%)

03/2017 CHECK PRINTS

COMMONWEALTH OF PENNSYLVANIA
PROFESSIONAL
WILLIAM W. WITMAN
ENGINEER

Provide scan of original seal and signature

REG. PROFESSIONAL ENGINEER
DATE: 02/24/17

WITMAN ENGINEERS & CONSULTANTS, LLC.


3417 MAIN ST.
MORGANTOWN, PA 19543

EMAIL: BILL@WITMANENGINEERS.COM

PHONE: 610-913-5680

DATE: 02/24/17 | PROJECT DESIGNER: WWW | JOB NO.: 3381

DRAWN BY: RLH | CHECKED BY: WWW

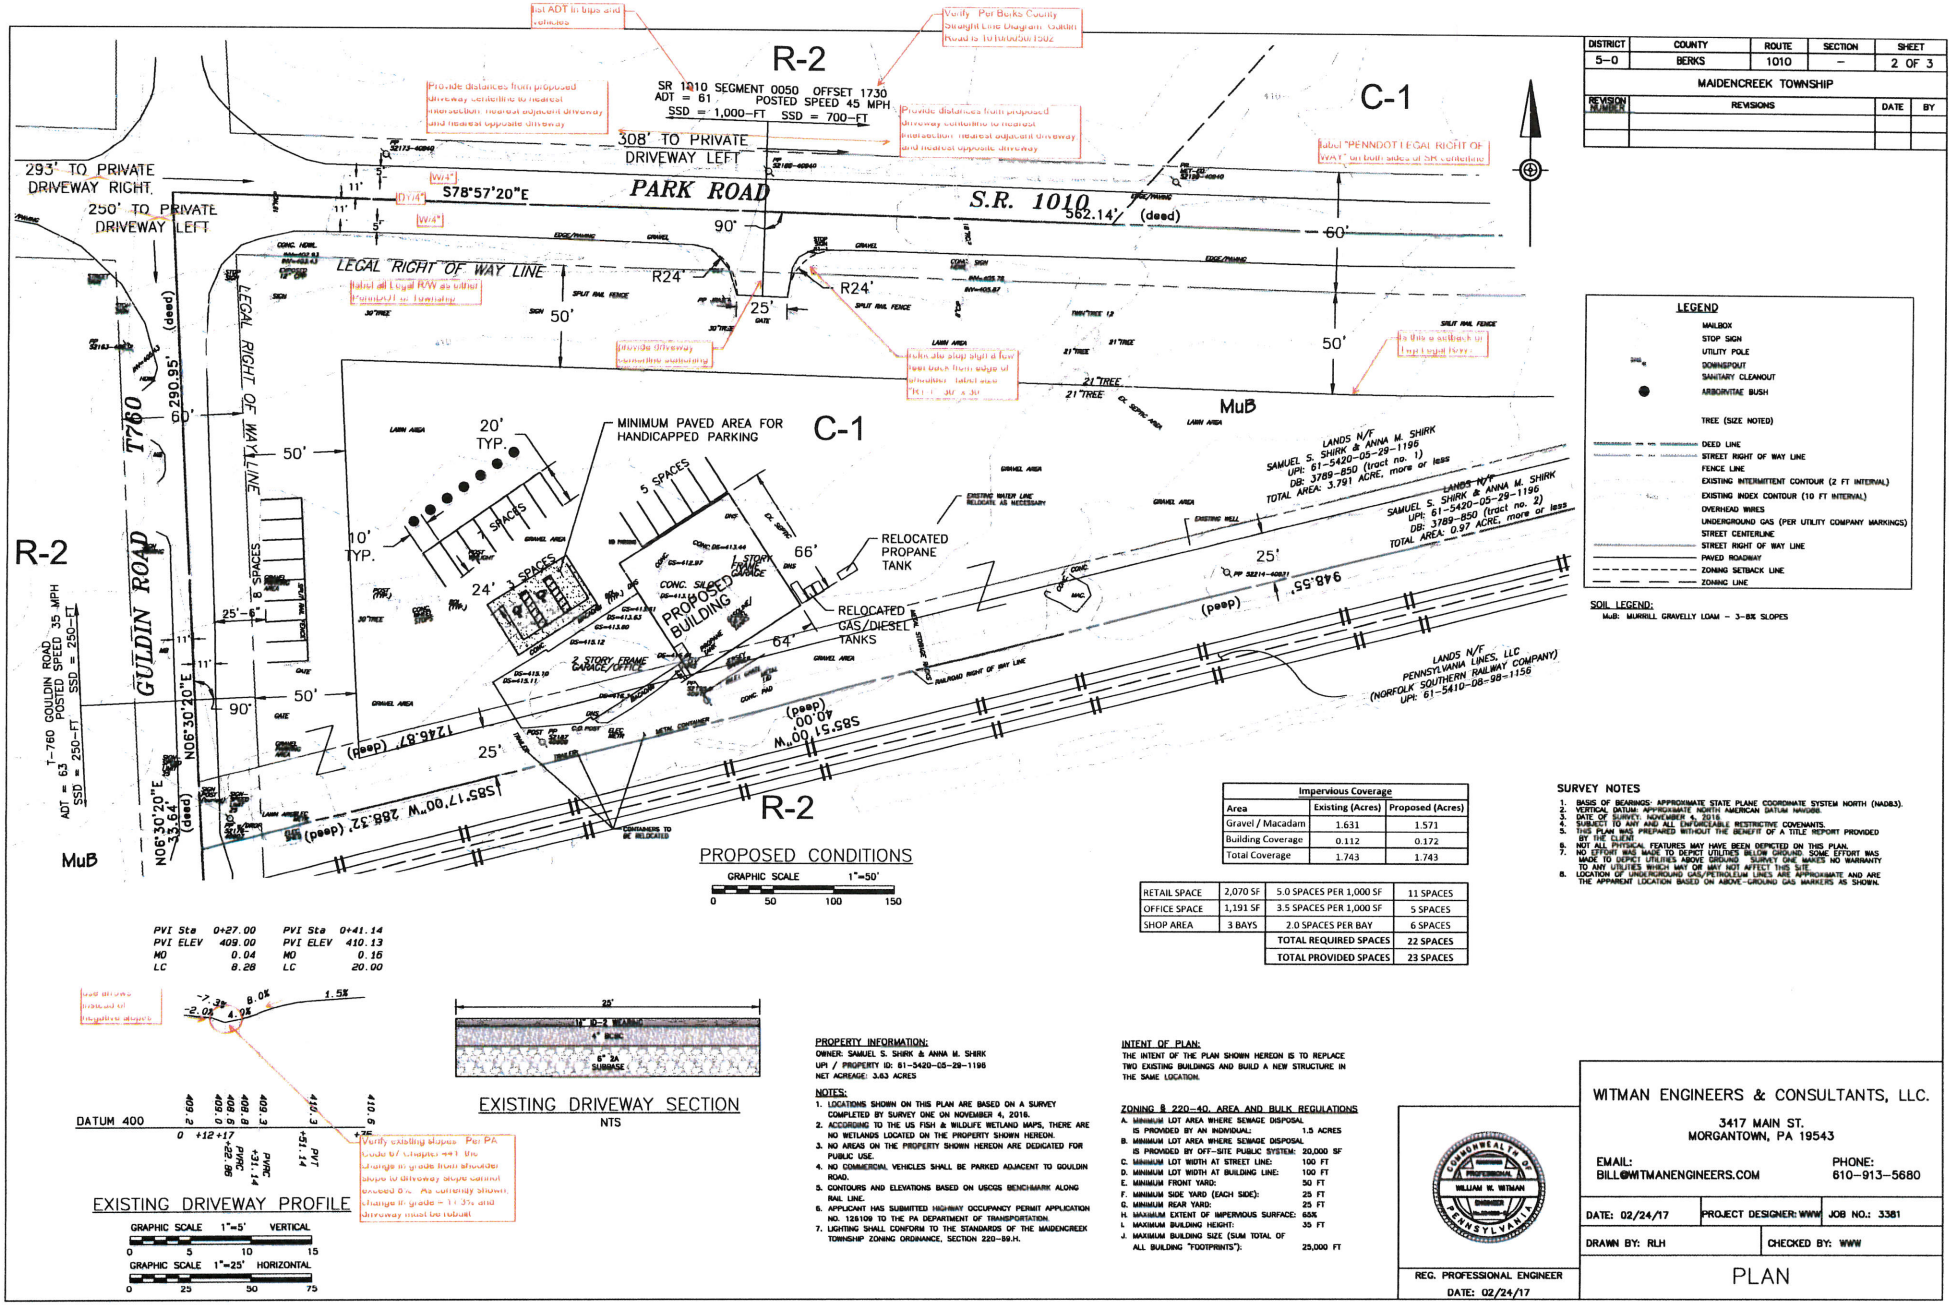

DISTRICT	COUNTY	ROUTE	SECTION	SHEET
5-0	BERKS	1010	-	2 OF 3
MAIDENCREEK TOWNSHIP				

REVISION NUMBER	REVISIONS	DATE	BY

LEGEND

MAILBOX
STOP SIGN
UTILITY POLE
DOWNSPOUT
SANITARY CLEANOUT
ARBORVITAE BUSH
TREE (SIZE NOTED)
DEED LINE
STREET RIGHT OF WAY LINE
FENCE LINE
EXISTING INTERMITTENT CONTOUR (2 FT INTERVAL)
EXISTING INDEX CONTOUR (10 FT INTERVAL)
OVERHEAD WIRES
UNDERGROUND GAS (PER UTILITY COMPANY MARKINGS)
STREET CENTERLINE
STREET RIGHT OF WAY LINE
PAVED ROADWAY
ZONING SETBACK LINE
ZONING LINE

SOIL LEGEND:
MuB: MURRILL GRAVELLY LOAM - 3-8% SLOPES

Impervious Coverage		
Area	Existing (Acres)	Proposed (Acres)
Gravel / Macadam	1.631	1.571
Building Coverage	0.112	0.172
Total Coverage	1.743	1.743

RETAIL SPACE	2,070 SF	5.0 SPACES PER 1,000 SF	11 SPACES
OFFICE SPACE	1,191 SF	3.5 SPACES PER 1,000 SF	5 SPACES
SHOP AREA	3 BAYS	2.0 SPACES PER BAY	6 SPACES
		TOTAL REQUIRED SPACES	22 SPACES
		TOTAL PROVIDED SPACES	23 SPACES

SURVEY NOTES

1. BASIS OF BEARINGS: APPROXIMATE STATE PLANE COORDINATE SYSTEM NORTH (NAD83).
2. VERTICAL DATUM: APPROXIMATE NORTH AMERICAN DATUM NAVD88.
3. DATE OF SURVEY: NOVEMBER 4, 2016.
4. SUBJECT TO ANY AND ALL ENFORCEABLE RESTRICTIVE COVENANTS.
5. THIS PLAN WAS PREPARED WITHOUT THE BENEFIT OF A TITLE REPORT PROVIDED BY THE CLIENT.
6. NOT ALL PHYSICAL FEATURES MAY HAVE BEEN DEPICTED ON THIS PLAN.
7. NO EFFORT WAS MADE TO DEPICT UTILITIES BELOW GROUND. SOME EFFORT WAS MADE TO DEPICT UTILITIES ABOVE GROUND. SURVEY ONE MAKES NO WARRANTY TO ANY UTILITIES WHICH MAY OR MAY NOT AFFECT THIS SITE.
8. LOCATION OF UNDERGROUND GAS/PETROLEUM LINES ARE APPROXIMATE AND ARE THE APPARENT LOCATION BASED ON ABOVE-GROUND GAS MARKERS AS SHOWN.

PVI Sta	0+27.00	PVI Sta	0+41.14
PVI ELEV	409.00	PVI ELEV	410.13
MO	0.04	MO	0.16
LC	8.28	LC	20.00

EXISTING DRIVEWAY PROFILE

GRAPHIC SCALE 1"=5' VERTICAL
0 5 10 15
GRAPHIC SCALE 1"=25' HORIZONTAL
0 25 50 75

EXISTING DRIVEWAY SECTION
NTS

PROPERTY INFORMATION:
OWNER: SAMUEL S. SHIRK & ANNA M. SHIRK
UPI / PROPERTY ID: 61-5420-05-29-1196
NET ACREAGE: 3.63 ACRES

NOTES:
1. LOCATIONS SHOWN ON THIS PLAN ARE BASED ON A SURVEY COMPLETED BY SURVEY ONE ON NOVEMBER 4, 2016.
2. ACCORDING TO THE US FISH & WILDLIFE WETLAND MAPS, THERE ARE NO WETLANDS LOCATED ON THE PROPERTY SHOWN HEREON.
3. NO AREAS ON THE PROPERTY SHOWN HEREON ARE DEDICATED FOR PUBLIC USE.
4. NO COMMERCIAL VEHICLES SHALL BE PARKED ADJACENT TO GOULDIN ROAD.
5. CONTOURS AND ELEVATIONS BASED ON USCGS BENCHMARK ALONG RAIL LINE.
6. APPLICANT HAS SUBMITTED HIGHWAY OCCUPANCY PERMIT APPLICATION NO. 126109 TO THE PA DEPARTMENT OF TRANSPORTATION.
7. LIGHTING SHALL CONFORM TO THE STANDARDS OF THE MAIDENCREEK TOWNSHIP ZONING ORDINANCE, SECTION 220-89.H.

INTENT OF PLAN:
THE INTENT OF THE PLAN SHOWN HEREON IS TO REPLACE TWO EXISTING BUILDINGS AND BUILD A NEW STRUCTURE IN THE SAME LOCATION.

ZONING § 220-40. AREA AND BULK REGULATIONS

A.	MINIMUM LOT AREA WHERE SEWAGE DISPOSAL IS PROVIDED BY AN INDIVIDUAL:	1.5 ACRES
B.	MINIMUM LOT AREA WHERE SEWAGE DISPOSAL IS PROVIDED BY OFF-SITE PUBLIC SYSTEM:	20,000 SF
C.	MINIMUM LOT WIDTH AT STREET LINE:	100 FT
D.	MINIMUM LOT WIDTH AT BUILDING LINE:	100 FT
E.	MINIMUM FRONT YARD:	50 FT
F.	MINIMUM SIDE YARD (EACH SIDE):	25 FT
G.	MINIMUM REAR YARD:	25 FT
H.	MAXIMUM EXTENT OF IMPERVIOUS SURFACE:	65%
I.	MAXIMUM BUILDING HEIGHT:	35 FT
J.	MAXIMUM BUILDING SIZE (SUM TOTAL OF ALL BUILDING "FOOTPRINTS"):	25,000 FT

COMMONWEALTH OF PENNSYLVANIA
PROFESSIONAL
WILLIAM W. WITMAN
ENGINEER

REG. PROFESSIONAL ENGINEER
DATE: 02/24/17

WITMAN ENGINEERS & CONSULTANTS, LLC.
3417 MAIN ST.
MORGANTOWN, PA 19543
EMAIL: BILL@WITMANENGINEERS.COM
PHONE: 610-913-5680

DATE: 02/24/17 | PROJECT DESIGNER: WWW | JOB NO.: 3381
DRAWN BY: RLH | CHECKED BY: WWW

PLAN

DISTRICT	COUNTY	ROUTE	SECTION	SHEET
5-0	BERKS	1010	-	3 OF 3
MAIDENCREEK TOWNSHIP				

REVISION NUMBER	REVISIONS	DATE	BY

GENERAL NOTES:

1. ALL WORK IN THE PENNDOT RIGHT-OF-WAY IS TO BE BUILT IN ACCORDANCE WITH:
   - A. PENNDOT PUBLICATION 408
   - B. PENNDOT PUBLICATIONS 34, 35, 41, AND 42
   - C. PENNDOT PUBLICATION 72M
   - D. PENNDOT PUBLICATIONS 148 AND 149
   - E. PENNDOT PUBLICATION 282
   - F. PENNDOT PUBLICATION 213 (67 PA CODE, CHAPTER 212)
   - G. PENNDOT PUBLICATION 70M
   - H. PENNDOT PUBLICATION 111
   - I. PENNDOT PUBLICATION 13M
   - J. PENNDOT PUBLICATION 236
   - K. PENNSYLVANIA CODE TITLE 67, CHAPTERS 441 AND 459
   - L. MANUAL ON UNIFORM TRAFFIC CONTROL DEVICES (MUTCD) - LATEST PENNDOT ADOPTED VERSION
2. THIS PERMIT MAY BE RESTRICTED ON WORKING HOURS AND TIMES FOR HOLIDAYS, WEEKENDS, AND SPECIAL UNFORESEEN EVENTS AND WILL REQUIRE APPROVAL FROM THE COUNTY OFFICE PRIOR TO WORKING DURING THESE PERIODS.
3. FOR PERMITS REQUIRING A STATE INSPECTOR, FOLLOWING THE PERMITTEE'S REQUEST, ALL WORK WITHIN THE RIGHT-OF-WAY SHALL BE COMPLETED WITHOUT TIME INTERRUPTIONS.
4. MATERIAL CERTIFICATIONS MUST BE PROVIDED BY AN APPROVED MANUFACTURER LISTED IN THE DEPARTMENT'S PUBLICATION 35, BULLETIN 15, FOR ALL MATERIALS AND STRUCTURES WITHIN THE PENNDOT RIGHT-OF-WAY.
5. ALL SLOPE MEASUREMENTS WILL BE INSPECTED/VERIFIED WITH A 2-FOOT SMART LEVEL.
6. FINAL APPROVAL OF THE PROPOSED SAWCUT LOCATION WILL BE AT THE DISCRETION OF THE INSPECTOR-IN-CHARGE AND WILL BE CONFIRMED AT THE PRE-CONSTRUCTION MEETING. IF THE SAWCUT MUST BE LOCATED WITHIN A TRAVEL LANE, IT WILL BE NECESSARY TO MILL AND OVERLAY THE TRAVEL LANE TO PREVENT A JOINT IN A WHEEL PATH.
7. MODIFICATIONS TO EXISTING DRAINAGE STRUCTURES MAY RESULT IN THE NEED TO REPLACE THE STRUCTURE. REPLACEMENT WILL BE AT THE DISCRETION OF THE INSPECTOR-IN-CHARGE.
8. CONTRACTOR WILL NOTIFY THE PENNDOT PRESS OFFICE AT 610-871-4555 A MINIMUM OF THREE WORKING DAYS PRIOR TO THE CLOSING OF TRAVEL LANE.
9. CONSTRUCT ALL PROPOSED PEDESTRIAN FACILITIES ON THESE PLANS TO COMPLY WITH THE AMERICANS WITH DISABILITIES ACT, PUBLIC RIGHT-OF-WAY ACCESSIBILITY GUIDELINES (PROWAG), AND THE ADA ACCESSIBILITY GUIDELINES (ADAAG).
10. PRIOR TO AN OVERLAY, BITUMINOUS OR CONCRETE BASE REPAIR OR JOINT REPLACEMENT MAY BE REQUIRED. REPAIR/REPLACEMENT WILL BE AT THE DISCRETION OF THE INSPECTOR IN CHARGE.
11. DETAILS, OTHER THAN THOSE INDICATED, ARE SHOWN ON THE FOLLOWING STANDARD DRAWINGS:
12. THREE WORKING DAYS PRIOR TO EXCAVATION, THE CONTRACTOR MUST CONTACT THE PA ONE CALL SYSTEM, INC. PHONE 1-800-242-1776, SERIAL NO. 20163561405 FOR MAIDENCREEK TOWNSHIP.
13. THE LEGAL RIGHT-OF-WAY ON SR 1010 IS 60 FEET BASED ON THE EXISTING EDGES OF PAVEMENT AND SHOULDER WIDTH. THERE IS NO OTHER PUBLIC RECORD.

MAINTENANCE AND PROTECTION OF TRAFFIC:

FURNISH, ERECT, PLACE AND MAINTAIN TRAFFIC CONTROL SIGNS AND DEVICES AND MAINTAIN TRAFFIC DURING HOURS OF CONSTRUCTION AND AT ALL OTHER TIMES IN ACCORDANCE WITH THE METHODS INDICATED ON THESE DRAWINGS AND:

1. THE SPECIAL PROVISIONS OF THE CONTRACT
2. PENNDOT PUBLICATION 213 (PA CODE, TITLE 67, CHAPTER 212, WORK ZONE TRAFFIC CONTROL)
3. PENNDOT PUBLICATION 35
4. PENNDOT PUBLICATION 408
5. PENNDOT PUBLICATION 111
6. PENNDOT PUBLICATION 236

IMMEDIATELY UPON COMPLETION OF THE WORK, REMOVE THE TRAFFIC CONTROL SIGNS AND DEVICES. THE DEPARTMENT WILL REMOVE ANY TRAFFIC CONTROL SIGNS AND DEVICES ERECTED BY DEPARTMENT FORCES.

THE INSPECTOR-IN-CHARGE WILL INSPECT ALL TRAFFIC CONTROL DEVICES PRIOR TO START OF WORK.

NO TRAFFIC RESTRICTIONS PERMITTED BETWEEN 6AM THRU 9AM AND 3PM THRU 6PM MONDAY THROUGH FRIDAY.

COVER OR REMOVE ALL CONFLICTING SIGNS AND SIGNS NOT IN USE.

REMOVE ALL CONFLICTING PAVEMENT MARKINGS.

ALL SIGNS ARE TO BE MOUNTED ON TYPE III BARRICADES UNLESS OTHERWISE NOTED.

ALL SIGNS ARE TO BE IN NEW OR LIKE NEW CONDITION AND MAINTAINED AS SUCH.

LOCATE ALL SIGNS SO THAT SIGHT DISTANCE WILL NOT BE OBSTRUCTED AT DRIVEWAYS AND SIDE STREETS.

ALL LONG TERM ADVANCE WARNING SIGNS TO BE TYPE III OR TYPE VII ORANGE RETROREFLECTIVE SHEETING MATERIAL.

THE CONTRACTOR IS TO NOTIFY THE LOCAL EMERGENCY UNITS (POLICE, FIRE, MEDICAL, ETC.), BUSINESSES, SCHOOL DISTRICT, AND THE GENERAL PUBLIC AT LEAST ONE WEEK PRIOR TO THE START OF WORK.

PROPERLY BARRICADE AND SECURE THE WORK AREA DURING WORKING HOURS TO PROVIDE FULL WIDTH USE FOR THROUGH TRAFFIC LANES UNDER SHORT TERM OPERATIONS. RETURN ALL LANES TO NORMAL TRAFFIC FLOW AT THE CLOSE OF THE WORKDAY.

REMOVE EXISTING DEPARTMENT WARNING, REGULATORY, GUIDE, AND DIRECTIONAL SIGNS AS REQUIRED TO ACCOMMODATE CONSTRUCTION OPERATION. DO NOT REMOVE STOP OR YIELD SIGNS UNLESS AN ALTERNATE TYPE OF TRAFFIC CONTROL IS PROVIDED, SUCH AS FLAGGERS, TEMPORARY TRAFFIC SIGNALS, ETC. CONTINUE THE ALTERNATE TRAFFIC CONTROL UNTIL STOP AND/OR YIELD SIGN ARE REPLACED.

THE FOLLOWING WORK ZONE TRAFFIC CONTROL, PUBLICATION 213, FIGURES ARE TO BE USED FOR THIS PROJECT: PATA 101

LIST OF PUBLIC UTILITIES:

COMPANY: AT&T ATLANTA
ADDRESS: 360 GEES MILL BUSINESS PKWY NE CONYERS, GA. 30013
CONTACT: NANCY SPENCE
EMAIL: NS2821@ATT.COM

COMPANY: COMCAST CABLE COMMUNICATIONS INC
ADDRESS: 400 RIVERFRONT DRIVE READING, PA. 19602
CONTACT: JEFF JACOVIDIS
EMAIL: JEFF_JACOVIDIS@CABLE.COMCAST.COM

COMPANY: BUCKEYE PARTNERS
ADDRESS: FIVE TEK PARK 9999 HAMILTON BLVD BREINIGSVILLE, PA. 18031
CONTACT: DAVE JONES
EMAIL: DAJONES@BUCKEYE.COM

COMPANY: MAIDENCREEK TOWNSHIP
ADDRESS: 1 QUARRY RD P.O. BOX 319 BLANDON, PA. 19510
CONTACT: KATELYN GRUBER
EMAIL: office@maidencreek.net

COMPANY: MAIDENCREEK TOWNSHIP AUTHORITY
ADDRESS: P.O. BOX 289 BLANDON, PA. 19510
CONTACT: PATRICK DONOVAN
EMAIL: MTAWATER@PTDPROLOG.NET

COMPANY: FIRSTENERGY CORP
ADDRESS: 76 S MAIN ST AKRON, OH. 44308-1890
CONTACT: OFFICE PERSONNEL

COMPANY: FRONTIER COMMUNICATIONS OF PA INC
ADDRESS: 67 S MAIN ST SHICKSHINNY, PA. 18655
CONTACT: JOHN BUGDONOVITCH
EMAIL: John.Bugdonovitch@ftr.com

COMPANY: READING AREA WATER AUTHORITY
ADDRESS: 1801 KUTZTOWN RD READING, PA. 19604
CONTACT: TRICIA SCHAEFFER
EMAIL: TRICIA.SCHAFFER@READINGAREAWATER.COM

COMPANY: SERVICE ELECTRIC CABLEVISION INC
ADDRESS: P.O. BOX 8 BIRDSBORO, PA. 19508
CONTACT: MIKE SPAYD
EMAIL: mike.spayd@secv.com

COMPANY: UGI UTILITIES INC
ADDRESS: 225 MORGANTOWN ROAD READING, PA. 19611
CONTACT: KURT ZIELASKOWSKI
EMAIL: kzielaskowski@ugi.com

COMMONWEALTH OF PENNSYLVANIA
PROFESSIONAL ENGINEER
WILLIAM W. WITMAN

REG. PROFESSIONAL ENGINEER
DATE: 02/24/17

WITMAN ENGINEERS & CONSULTANTS, LLC.
3417 MAIN ST.
MORGANTOWN, PA 19543
EMAIL: BILL@WITMANENGINEERS.COM
PHONE: 610-913-5680

DATE: 02/24/17 | PROJECT DESIGNER: WWW | JOB NO.: 3381
DRAWN BY: RLH | CHECKED BY: WWW

GENERAL NOTES